

NOTICE OF PUBLIC HEARING

HEARING DATE: Wednesday, September 7, 2022 at 4:00 pm

PLACE: This will be a virtual / electronic meeting

Town Council approved Committee of Adjustment Hearings to be held electronically through By-law 4422(2022).

The Town of Pelham Committee of Adjustment meeting live webcast will be streaming at: <https://www.youtube.com/user/TownOfPelham>


Under Section 45 of the Planning Act, R.S.O. 1990, as amended, notice is hereby given that an application for **minor variance** or permission will be heard by the Committee of Adjustment for the Town of Pelham at the date and place shown above.

File Number: A11/2022P

Subject Lands: 1 Joyce Crescent, Pelham

Legal Description: Lot 66 on Plan 59M-403

The subject land is located on the north side of Joyce Crescent, lying east of Buckley Terrace, being Lot 66 on Plan 59M-403, in the Town of Pelham.

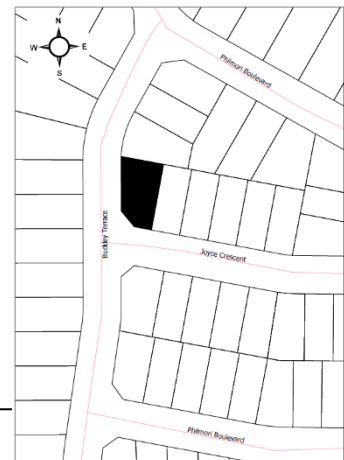

Nature and Extent of Relief/ Permission Applied for:

The subject land is zoned a site-specific Residential 1-184 (R1-184) in accordance with Pelham Zoning Amending By-law 3325(2012), as amended. Application is made for relief, to construct a rear deck, from:

By-law 3325(2012), Section R1-184(f)(i) "Minimum Exterior Side Yard" – to permit a minimum exterior side yard of 1.06m whereas the by-law requires 3m; and

By-law 3325(2012), Section R1-184(g) "Minimum Rear Yard" – to permit a minimum rear yard of 2.74m whereas the by-law requires 7.5m.

PUBLIC HEARING: This is a public hearing called for the purpose of hearing evidence for, or in opposition to, the above noted application. Anyone wishing to register objections, support or comments concerning this application may present them in writing to the Secretary-Treasurer prior to the hearing and/or at the hearing, or make a verbal presentation at the hearing.

YOUR INPUT IS ENCOURAGED: The Committee would appreciate receiving your written and/or verbal comments regarding this application. **Written comments must be submitted by August 24, 2022.** If the Secretary-Treasurer does not receive your comments by this date, it may be presumed you have no objection to the proposal. Should an extension be required, please contact the Secretary-Treasurer. Verbal comments will be received by the Committee at the electronic public hearing via Zoom. **To participate in the virtual meeting to provide oral input, please pre-register with the Secretary Treasurer by sending an email to the email address noted below before 12:00pm noon on September 2, 2022.** All registrants will be provided with instructions on how to use your computer, tablet or phone to participate in the remote electronic public meeting. Registrants will be notified of the Committee of Adjustments Decision. If you have not submitted written comments or pre-registered and wish to submit a comment during the meeting, you may livestream the meeting from our YouTube Channel and e-mail comments to clerks@pelham.ca during the public comment portion of the application only. If your comments are not received during the public portion of the application, they will not be considered. Unless indicated otherwise, personal information and all comments will become part of the public record and may be publicly released.

It is highly recommended that the applicant or the authorized agent of the applicant be present at the hearing. Please note that if you do not attend at this hearing, the Committee may proceed in your absence and you will not be entitled to any further notice in the proceedings.

NOTICE OF DECISION: Requests for copies of the decision of the Committee of Adjustment or notice of adjournment of hearing, if any, must be in writing and addressed to:

Secretary Treasurer of the Committee of Adjustment
20 Pelham Town Square, P.O. Box 400, Fonthill ON L0S 1E0
905-892-2607 ext. 315 hwillford@pelham.ca

For technical questions, please contact:

Andrew Edwards, Planner
905-892-2607 ext. 324 aedwards@pelham.ca




Holly Willford
Town Clerk/Secretary-Treasurer

Date of Mailing: August 10, 2022



1 SITE PLAN
SCALE: 1/32" = 1'

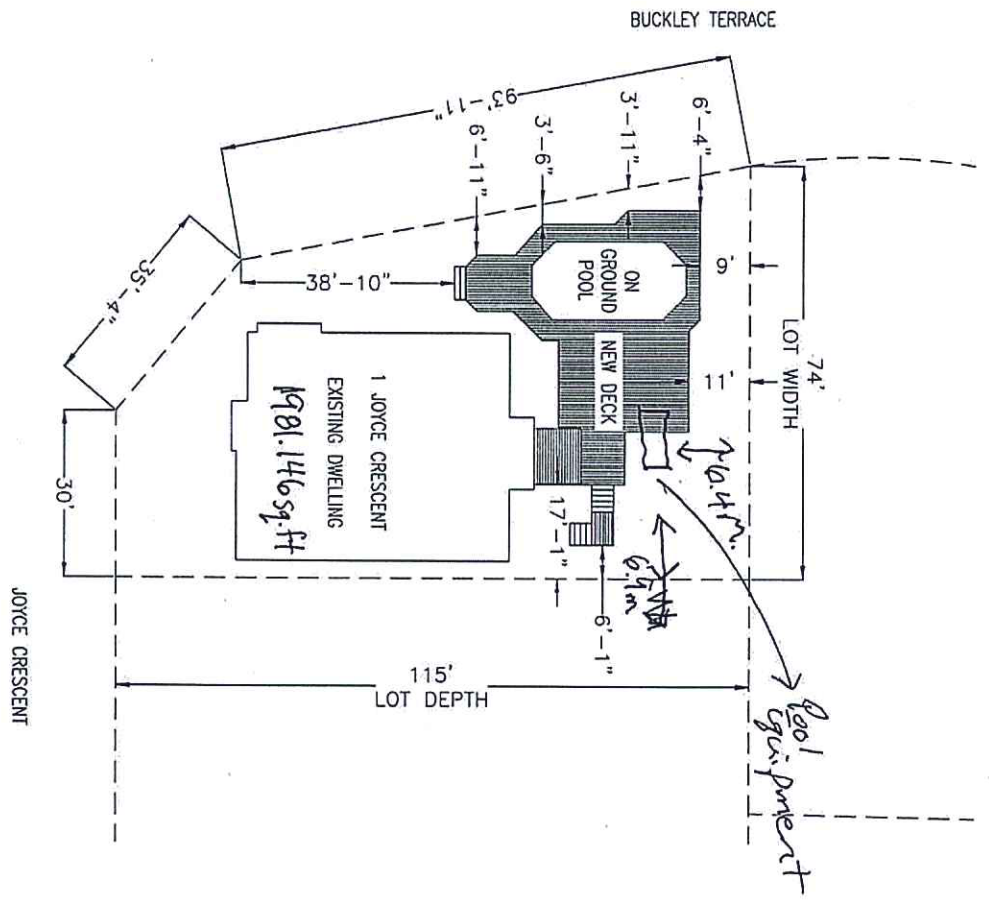

HICKORY DICKORY DECKS
 Hickory Dickory Decks
 Head Office
 115 Dundas St W (Highway #5)
 Dundas, ON L9H 7L6
 P: 905-689-4774
 E: hddoffice@gmail.com

Project Address:
**1 JOYCE CRESCENT
 FONTHILL, LOS 1E5**

I have reviewed and take responsibility for the design and am qualified in the appropriate category as a designer under subsection 3.2.5 of Division C of the Ontario Building Code.
 Name: Brad Arnold (BCIN # 24758)
 Signature:

Drawn By:	STEPHANIE ALLEN	10
Date:	MAY 31, 2022	15

Electronic Hearing Procedures &

How to Get Involved in a Town of Pelham Zoom Hearing

All Town of Pelham in person Committee of Adjustment hearings have been cancelled, instead the Town is holding all Committee of Adjustment hearings electronically via Zoom.

Notice of Hearing

A Notice of Hearing will be mailed to the all persons listed as owners in the last revised assessment roll number within 60 meters (200 feet) of the subject property. The Notice of Hearing can also be found at the Town of Pelham website for all applications being heard by electronic meetings: <https://www.pelham.ca/en/town-hall/committee-of-adjustment.aspx>

How to Submit Comments

Public input on applications is invited. During this time, written comments are encouraged as the preferred method of receiving public input. Written comments may be sent by mail or e-mail to the attention of the Secretary Treasurer. You may also drop written comments off at Town Hall in the drop box. You may also provide oral input by joining the electronic meeting.

Written Comments

Please provide written input by mailing or e-mailing your comments to the Secretary Treasurer by the date indicated on the Notice of Hearing. You may also drop off written comments to Town Hall in the drop box.

Oral Submissions

To participate in the remote electronic public meeting to provide oral input, please pre-register with the Secretary Treasurer by telephone or email by the date indicated on the Notice of Hearing. All registrants will be provided in advance of the meeting instructions on how to use your computer, tablet or phone to participate in the electronic meeting.

Please note, the Secretary Treasurer will provide you the Zoom link and password in advance of the meeting. This is for pre-registered participants only and is not to be shared with others.

View the Meeting – E-mail Comments Live

The remote electronic meeting can be viewed by live-streamed on the Town's YouTube Channel at <https://www.youtube.com/user/TownOfPelham>. While viewing the meeting live you may submit comments during your application of interest to: clerks@pelham.ca. Please note, if your comments are submitted after the public portion of the application you are interested in has been closed, your comments will not be considered. This method of public participation is not the preferred method as you may not submit your comments in time. Use this method at your own risk and the Town is not responsible for any livestream lag, disconnection or internet failures.

More Information

For more information please contact:

Secretary Treasurer of the Committee of Adjustment
20 Pelham Town Square, P.O. Box 400, Fonthill ON L0S 1C0
905-892-2607 ext. 315 hwillford@pelham.ca

Assistant Secretary Treasurer of the Committee of Adjustment
20 Pelham Town Square, P.O. Box 400, Fonthill ON L0S 1C0
905-892-2607 ext. 320 sleach@pelham.ca

For technical questions, please
contact: Andrew Edwards Planner
905-892-2607 ext. 324 aedwards@pelham.ca

Test Session

If you would like to test your video / audio prior to the public hearing, please indicate this to the Secretary-Treasurer upon registering to participate. Test meetings will occur on 2pm the Friday before the public hearing. Test meetings will only be scheduled upon request.

Participant Process During Meetings

- Participants are required to join the meeting 15 minutes in advance of the start time for the Hearing.
- Participants are responsible for ensuring their background is free from offensive or vulgar material. If inappropriate material is visible you will be removed from the meeting.
- Vulgar or offensive language / comments will not be tolerated. If inappropriate language is used you will be removed from the meeting.
- Participants' microphones will remain off until they are called to speak.
- Once your comments have been heard by the Committee of Adjustment, your microphone will again be muted. Once voting on the item has taken place, participants will be removed from the meeting completely.
- Once removed from the Hearing, you can visit the Town's YouTube if you wish to continue watching the meeting.

Technical Difficulties During Hearings

- Beyond the mandatory training session, Town staff will **not** provide technical assistance for participants before or during Hearings.
- If a participant's connection to the meeting fails during the Hearing, Town Staff will attempt to make reasonable efforts to re-establish connection for a period of 5 minutes. If the connection cannot be re-established within 5 minutes, the comments received up to that point will be included as part of the official record and the hearing will continue.
- If a participant is not present when called upon by the Chair three times, the participant will be considered absent and the hearing will continue without the participant.
- If, in the Chair's opinion, a participant's audio / video is not of an acceptable quality, the Chair may require the participant to use the dial-in option or may defer the application until a regular hearing can be held.