

NOTICE OF PUBLIC HEARING**HEARING DATE:** **Wednesday, September 8, 2021 at 4:00 pm****PLACE:** **This will be a virtual / electronic meeting****Town Council approved Committee of Adjustment Hearings to be held electronically through By-law 4296(2020).****The Town of Pelham Committee of Adjustment meeting live webcast will be streaming at: <https://www.youtube.com/user/TownOfPelham>**

Under Section 45 of the Planning Act, R.S.O. 1990, as amended, notice is hereby given that an application for **minor variance** or permission will be heard by the Committee of Adjustment for the Town of Pelham at the date and place shown above.

File Number: **A33/2021P****Subject Lands:** **18 Beechwood Crescent, Pelham****Legal Description:** **Lot 34 on Plan 59M-189**

The subject land is located on the south side of Beechwood Crescent lying west of Kunda Park Boulevard, being Lot 34 on Plan 59M-189, in the Town of Pelham

**Nature and Extent of Relief/ Permission Applied for:**

The subject land is zoned Residential 'R1' in accordance with Pelham Zoning By-law 1136(1987), as amended. Application is made for relief, to construct a covered porch, from:

Section 13.2(c) "Maximum Lot Coverage" – to permit a 40% lot coverage whereas the by-law allows 30% and whereas the property received a minor variance approval to allow 34%.

PUBLIC HEARING: This is a public hearing called for the purpose of hearing evidence for, or in opposition to, the above noted application. Anyone wishing to register objections, support or comments concerning this application may present them in writing to the Secretary-Treasurer prior to the hearing and/or at the hearing, or make a verbal presentation at the hearing.

YOUR INPUT IS ENCOURAGED: The Committee would appreciate receiving your written and/or verbal comments regarding this application. **Written comments must be submitted by August 25, 2021.** If the Secretary-Treasurer does not receive your comments by this date, it may be presumed you have no objection to the proposal. Should an extension be required, please contact the Secretary-Treasurer. Verbal comments will be received by the Committee at the electronic public hearing via Zoom. **To participate in the virtual meeting to provide oral input, please pre-register with the Secretary Treasurer by sending an email to the email address noted below before 12:00pm noon on Friday, September 3, 2021.** All registrants will be provided with instructions on how to use your computer, tablet or phone to participate in the remote electronic public meeting. Registrants will be notified of the Committee of Adjustments Decision. If you have not submitted written comments or pre-registered and wish to submit a comment during the meeting, you may livestream the meeting from our YouTube Channel and e-mail comments to clerks@pelham.ca during the public comment portion of the application only. If your comments are not received during the public portion of the application, they will not be considered. Unless indicated otherwise, personal information and all comments will become part of the public record and may be publicly released.

It is highly recommended that the applicant or the authorized agent of the applicant be present at the hearing. Please note that if you do not attend at this hearing, the Committee may proceed in your absence and you will not be entitled to any further notice in the proceedings.

NOTICE OF DECISION: Requests for copies of the decision of the Committee of Adjustment or notice of adjournment of hearing, if any, must be in writing and addressed to:

Secretary Treasurer of the Committee of Adjustment
20 Pelham Town Square, P.O. Box 400, Fonthill ON L0S 1E0
905-892-2607 ext. 320 hwillford@pelham.ca

For technical questions, please contact:
Kenny Ng, Planner
905-892-2607 ext. 324 kng@pelham.ca

Date of Mailing: July 28, 2021

Holly Willford
Town Clerk/Secretary-Treasurer

BEECHWOOD (BY P1) CRESCENT


SURVEYOR'S REAL PROPERTY REPORT

PLAN OF LOT 34

PART 1

PIN 64067-0046(LT)

N89°19'45"E (REFERENCE BEARING)(P1) 15.842 (P1 & SET) 19.000 (P1 & MEAS) IB 1495

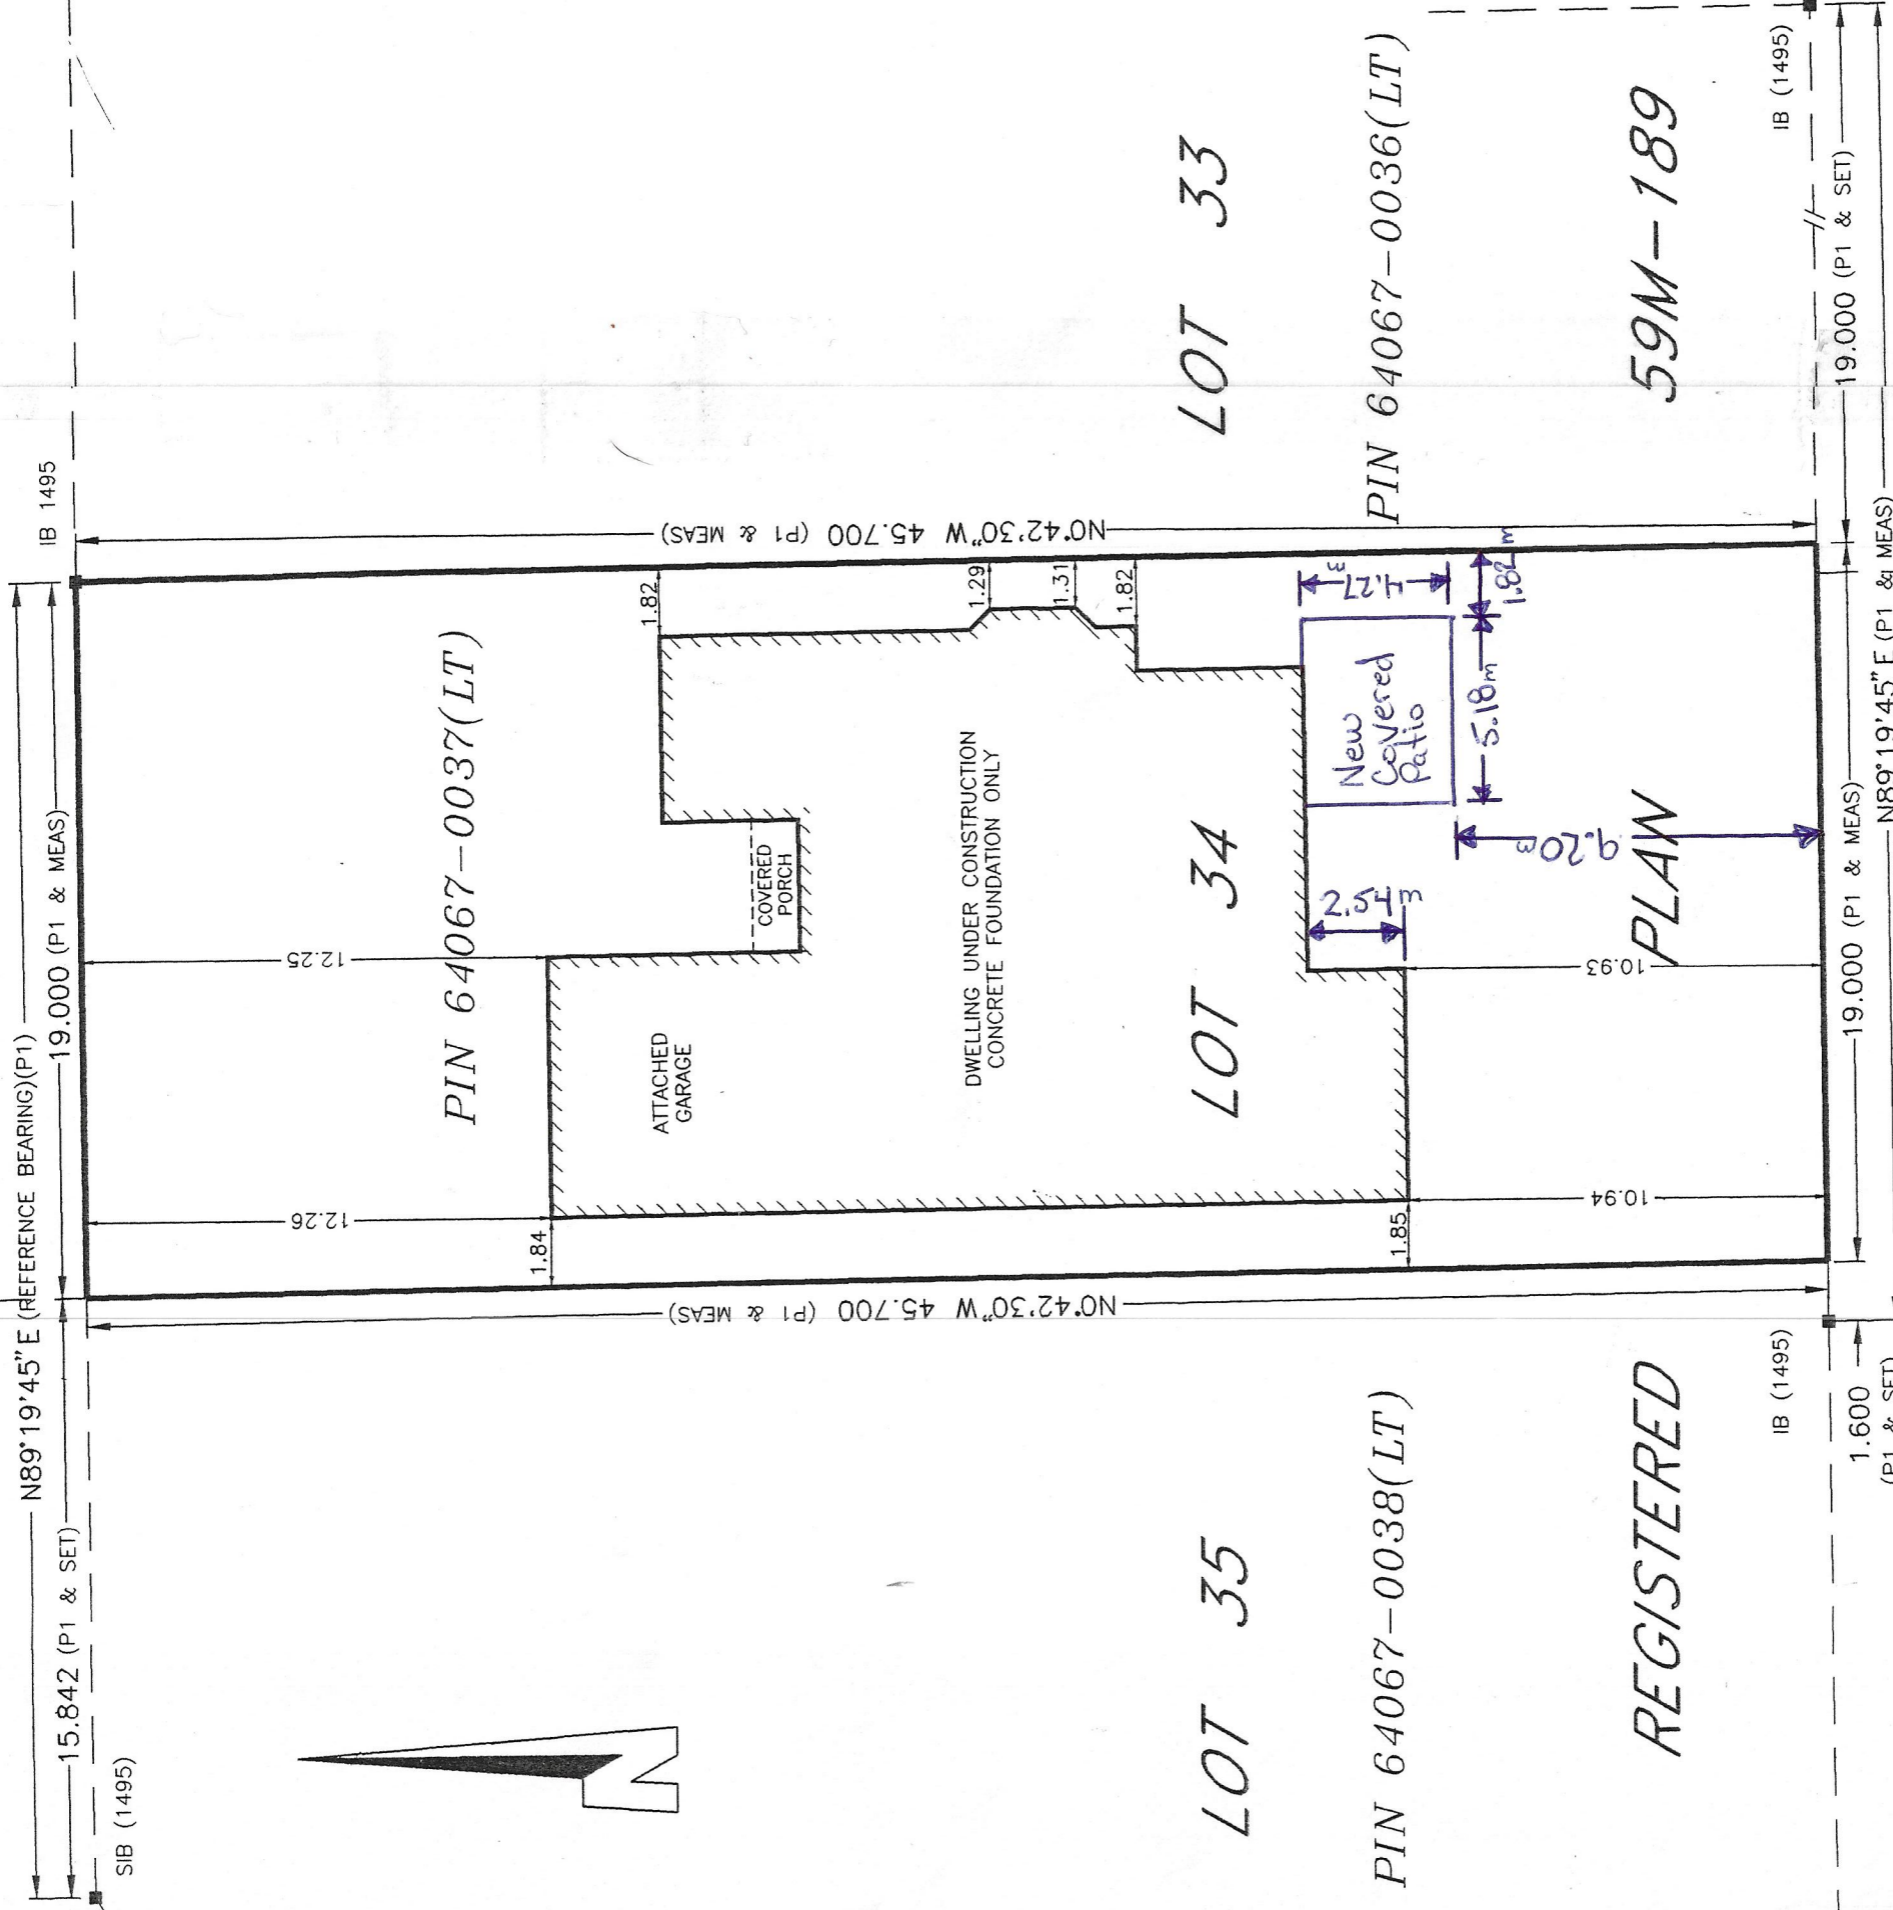

LOT 35

PIN 64067-0038(LT)

LOT 34

LOT 33

PIN 64067-0036(LT)

REGISTERED

LOT 28

PIN 64067-0030(LT)


LOT 27

PIN 64067-0029(LT)

LOT 26

PIN 64067-0028(LT)

SCALE 1 : 200

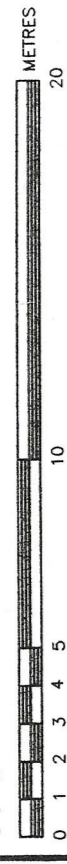

P. DOUGLAS REITSMA
ONTARIO LAND SURVEYOR

© COPYRIGHT 2000

THE REPRODUCTION, ALTERATION, OR USE OF THIS REPORT, IN WHOLE OR IN PART, WITHOUT THE EXPRESS WRITTEN PERMISSION OF P. D. REITSMA SURVEYING LTD., IS STRICTLY PROHIBITED.

PART 2 THIS PLAN MUST BE READ IN CONJUNCTION WITH SURVEY REPORT DATED 11/11/2000

NOTES

ALL BUILDING TIES ARE PERPENDICULAR TO PROPERTY LINES UNLESS SHOWN OTHERWISE.
ALL TIES ARE TO FOUNDATION UNLESS OTHERWISE NOTED.

BEARINGS ARE ASTROMOMIC AND ARE REFERRED TO THE SOUTHERLY LIMIT OF BEECHWOOD CRESCENT AS SHOWN ON REGISTERED PLAN 59M-189 ON A COURSE OF N89°19'45"E.

LEGEND

- DENOTES SURVEY MONUMENT FOUND
- SURVEY MONUMENT SET
- SIB STANDARD IRON BAR
- SSIB SHORT STANDARD IRON BAR
- IB IRON BAR
- CP CONCRETE PIN
- RIB ROUND IRON BAR
- IP IRON PIPE
- MEAS MEASURED
- WIT WITNESS
- OU ORIGIN UNKNOWN
- N/S/E/W NORTH/SOUTH/EAST/WEST
- NKA NOW KNOWN AS
- PIN PROPERTY IDENTIFICATION NUMBER
- P1 REGISTERED PLAN 59M-189
- 1495 P.D. REITSMA, O.L.S.

METRIC NOTE

DISTANCES SHOWN ON THIS PLAN ARE IN METRES AND CAN BE CONVERTED TO FEET BY DIVIDING BY 0.3048.

NOTE: THIS REPORT CAN BE UPDATED BY THIS OFFICE, HOWEVER NO ADDITIONAL PRINTS OF THIS ORIGINAL REPORT WILL BE ISSUED SUBSEQUENT TO THE DATE OF CERTIFICATION.

THIS REPORT WAS PREPARED FOR MIKE AZOTINI FOR USE IN A CURRENT TRANSACTION AND THE UNDERSIGNED ACCEPTS NO RESPONSIBILITY FOR USE BY OTHER PARTIES.

SURVEYOR'S CERTIFICATE

- I CERTIFY THAT:
- 1) THIS SURVEY AND PLAN ARE CORRECT AND IN ACCORDANCE WITH THE SURVEYS ACT, THE SURVEYORS ACT, THE LAND TITLES ACT, AND THE REGULATIONS MADE UNDER THEM.
 - 2) THE SURVEY WAS COMPLETED ON THE 12th. DAY OF APRIL, 2000.

DATE _____ P. DOUGLAS REITSMA, B.Sc., O.L.S.

ASSOCIATION OF ONTARIO LAND SURVEYORS
PLAN SUBMISSION FORM
1293426



THIS PLAN IS NOT VALID UNLESS IT IS AN EMBOSSED ORIGINAL COPY ISSUED BY THE SURVEYOR In accordance with Regulation 1028, Section 29(3).

P. D. REITSMA SURVEYING LTD.
203 EAST MAIN STREET (Upper)
WELLAND ONTARIO L3B-3W7
(905) 735-7841

Electronic Hearing Procedures &

How to Get Involved in a Town of Pelham Zoom Hearing

All Town of Pelham in person Committee of Adjustment hearings have been cancelled, instead the Town is holding all Committee of Adjustment hearings electronically via Zoom.

Notice of Hearing

A Notice of Hearing will be mailed to the all persons listed as owners in the last revised assessment roll number within 60 meters (200 feet) of the subject property. The Notice of Hearing can also be found at the Town of Pelham website for all applications being heard by electronic meetings: <https://www.pelham.ca/en/town-hall/committee-of-adjustment.aspx>

How to Submit Comments

Public input on applications is invited. During this time, written comments are encouraged as the preferred method of receiving public input. Written comments may be sent by mail or e-mail to the attention of the Secretary Treasurer. You may also drop written comments off at Town Hall in the drop box. You may also provide oral input by joining the electronic meeting.

Written Comments

Please provide written input by mailing or e-mailing your comments to the Secretary Treasurer by the date indicated on the Notice of Hearing. You may also drop off written comments to Town Hall in the drop box.

Oral Submissions

To participate in the remote electronic public meeting to provide oral input, please pre-register with the Secretary Treasurer by telephone or email by the date indicated on the Notice of Hearing. All registrants will be provided in advance of the meeting instructions on how to use your computer, tablet or phone to participate in the electronic meeting.

Please note, the Secretary Treasurer will provide you the Zoom link and password in advance of the meeting. This is for pre-registered participants only and is not to be shared with others.

View the Meeting – E-mail Comments Live

The remote electronic meeting can be viewed by live-streamed on the Town's YouTube Channel at <https://www.youtube.com/user/TownOfPelham>. While viewing the meeting live you may submit comments during your application of interest to: clerks@pelham.ca. Please note, if your comments are submitted after the public portion of the application you are interested in has been closed, your comments will not be considered. This method of public participation is not the preferred method as you may not submit your comments in time. Use this method at your own risk and the Town is not responsible for any livestream lag, disconnection or internet failures.

More Information

For more information please contact:

Secretary Treasurer of the Committee of Adjustment
20 Pelham Town Square, P.O. Box 400, Fonthill ON L0S 1C0
905-892-2607 ext. 315 hwillford@pelham.ca

Assistant Secretary Treasurer of the Committee of Adjustment
20 Pelham Town Square, P.O. Box 400, Fonthill ON L0S 1C0
905-892-2607 ext. 320 sleach@pelham.ca

For technical questions, please contact:
Kenny Ng, Planner
905-892-2607 ext. 324 kng@pelham.ca

Test Session

Prior to the Committee of Adjustment hearing, participants are required to take part in a test Zoom session with Town staff. Testing will cover the audio and video quality of the participant's device; reviewing the process for participants to join the meeting; and reviewing the presentation process.

The test session will be held on the Monday prior to the meeting. The test session should take less than 15 minutes to complete. Note: other members of the public may be in the same test session. The Secretary-Treasurer or Assistant Secretary Treasurer will contact you via email with your test session information.

Participant Process During Meetings

- Participants are required to join the meeting 15 minutes in advance of the start time for the Hearing.
- Participants are responsible for ensuring their background is free from offensive or vulgar material. If inappropriate material is visible you will be removed from the meeting.
- Vulgar or offensive language / comments will not be tolerated. If inappropriate language is used you will be removed from the meeting.
- Participants' microphones will remain off until they are called to speak.
- Once your comments have been heard by the Committee of Adjustment, your microphone will again be muted. Once voting on the item has taken place, participants will be removed from the meeting completely.
- Once removed from the Hearing, you can visit the Town's YouTube if you wish to continue watching the meeting.

Technical Difficulties During Hearings

- Beyond the mandatory training session, Town staff will **not** provide technical assistance for participants before or during Hearings.
- If a participant's connection to the meeting fails during the Hearing, Town Staff will attempt to make reasonable efforts to re-establish connection for a period of 5 minutes. If the connection cannot be re-established within 5 minutes, the comments received up to that point will be included as part of the official record and the hearing will continue.
- If a participant is not present when called upon by the Chair three times, the participant will be considered absent and the hearing will continue without the participant.
- If, in the Chair's opinion, a participant's audio / video is not of an acceptable quality, the Chair may require the participant to use the dial-in option or may defer the application until a regular hearing can be held.